

TOPOGRAPHIC SURVEY

BENCHMARK UTILIZED: NGSS #QE0391
ELEV: 451.61' NAVD 88

MARK IS A 4" ALUMINUM DISK IN TOP FACE OF CURB RETURN
AT NORTHWEST CORNER OF INTERSECTION OF WATER STREET
AND 1ST AVENUE IN STAYTON.

DISCLAIMER: UTILITIES DEPICTED ARE BASED ON
EVIDENCE FOUND IN THE FIELD, MUNICIPALITY AND/OR
OTHER GOVERNMENT ENTITY AS-BUILT PLANS,
CONTRACTOR PLANS AND OTHER DOCUMENTS OF
RECORD. BARKER SURVEYING ASSUMES NO
RESPONSIBILITY FOR UTILITIES THAT ARE NO LONGER IN
USE, INSTALLED AFTER THE DATE OF ACTUAL SURVEY,
NOT IDENTIFIED OR NOT LOCATED. THIS INCLUDES
UTILITIES UPON PUBLIC OR PRIVATE PROPERTY.

SPECIFIC UTILITY POSITIONS INDICATED ON THE GROUND
SURFACE PROVIDED BY LOCATION SERVICES MAY VARY
DUE TO UNDERGROUND DETECTION CAPABILITIES.

ABBREVIATIONS


ASPH	ASPHALT	IRR	IRRIGATION
AD	AREA DRAIN	IE	INVERT ELEVATION
ASSY	ASSEMBLY	JB	JUNCTION BOX
BLDG, BLD	BUILDING	LP	LIGHT POLE
BSW	BRASS SCREW W/WASHER	M	METER, MAIN
CATV	CABLE TELEVISION	MB	MAILBOX
CB	CATCH BASIN	MH	MANHOLE
CO	CLEAN-OUT	OH	OVER-HEAD
CONC	CONCRETE	P/L	PROPERTY LINE
CL	CENTERLINE	PP	POWER POLE
DIP	DUCTILE IRON PIPE	PVC	POLYVINYL CHLORIDE
EG	EDGE OF GRAVEL	PWR	POWER
EOP, EP	EDGE OF PAVEMENT	R	RADIUS
ELEV	ELEVATION	ROW, R/W	RIGHT-OF-WAY
EX, EXIST	EXISTING	SS	SANITARY SEWER
FDC	FIRE DEPT. CONNECTOR	SD	STORM DRAIN
FT	FEET	SVC	SERVICE
FF	FINISH FLOOR	SWK, S/W	SIDEWALK
FG	FINISH GRADE	TC	TOP OF CURB
FH	FIRE HYDRANT	TEL	TELEPHONE
FI	FIELD INLET	TR	TRANSFORMER
FM	FORCE MAIN	TS	TRAFFIC SIGNAL
GRAV	GRAVEL	TW	TOP OF WALL
GM	GAS METER	TYP	TYPICAL
GP	GATE POST	UG, U/G	UNDER GROUND
GS	GROUND SHOT	UTIL	UTILITY
GV	GAS VALVE	VL	VAULT
HC	HANDICAP	W	WITH
HDPE	HIGH-DENSITY POLYETHYLENE	WM	WATER METER
HYD	HYDRANT	WLM	WETLANDS MARKER
IR	IRON ROD	YPC	YELLOW PLASTIC CAP
IP	IRON PIPE		

SYMBOLS




AD	AREA DRAIN	SP	SIGN POST
CD or CD	CATCH BASIN	PED	PEDESTAL
CO	CLEANOUT	MB	MAIL BOX
FD	FIRE HYDRANT	IV	IRRIGATION VALVE
GV	GAS VALVE	LP	LIGHT POLE
WV	WATER VALVE	UP	UTILITY/POWER POLES
GPW	GAS/POWER/WATER METER	TP	TEST PIT
DSO	DOWN SPOUT	MF	MONUMENT FOUND
MT	MANHOLE TELEPHONE		
MSD	MANHOLE STORM DRAIN		
MSW	MANHOLE SANITARY SEWER		
TS	TREES - *TREENAME* DIAMETER (INCHES)/DRIP RADIUS (FEET)		
NOTE:	DIAMETER MEASURED AT BREAST HEIGHT		

LINE TYPES

CATV LINE	CATV
COMMUNICATION LINE	COM
EASEMENT LINE	EAS
FENCE LINE	FEN
FIBER OPTIC LINE	FOC
GAS LINE	GAS
EDGE OF GRAVEL LINE	EG
OVERHEAD LINE	OH
PHONE LINE	PH
POWER LINE	PWR
SANITARY SEWER LINE	SS
STORM DRAIN LINE	SD
WATER LINE	W

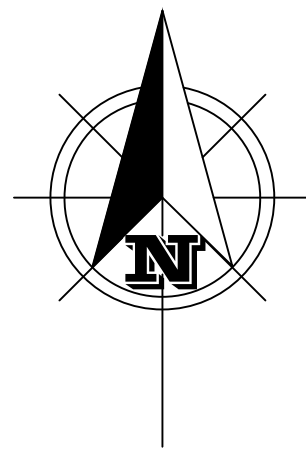

GRAPHIC SCALE
20' 10' 0' 10' 20' 40'
(IN FEET)
1 inch = 20 ft.

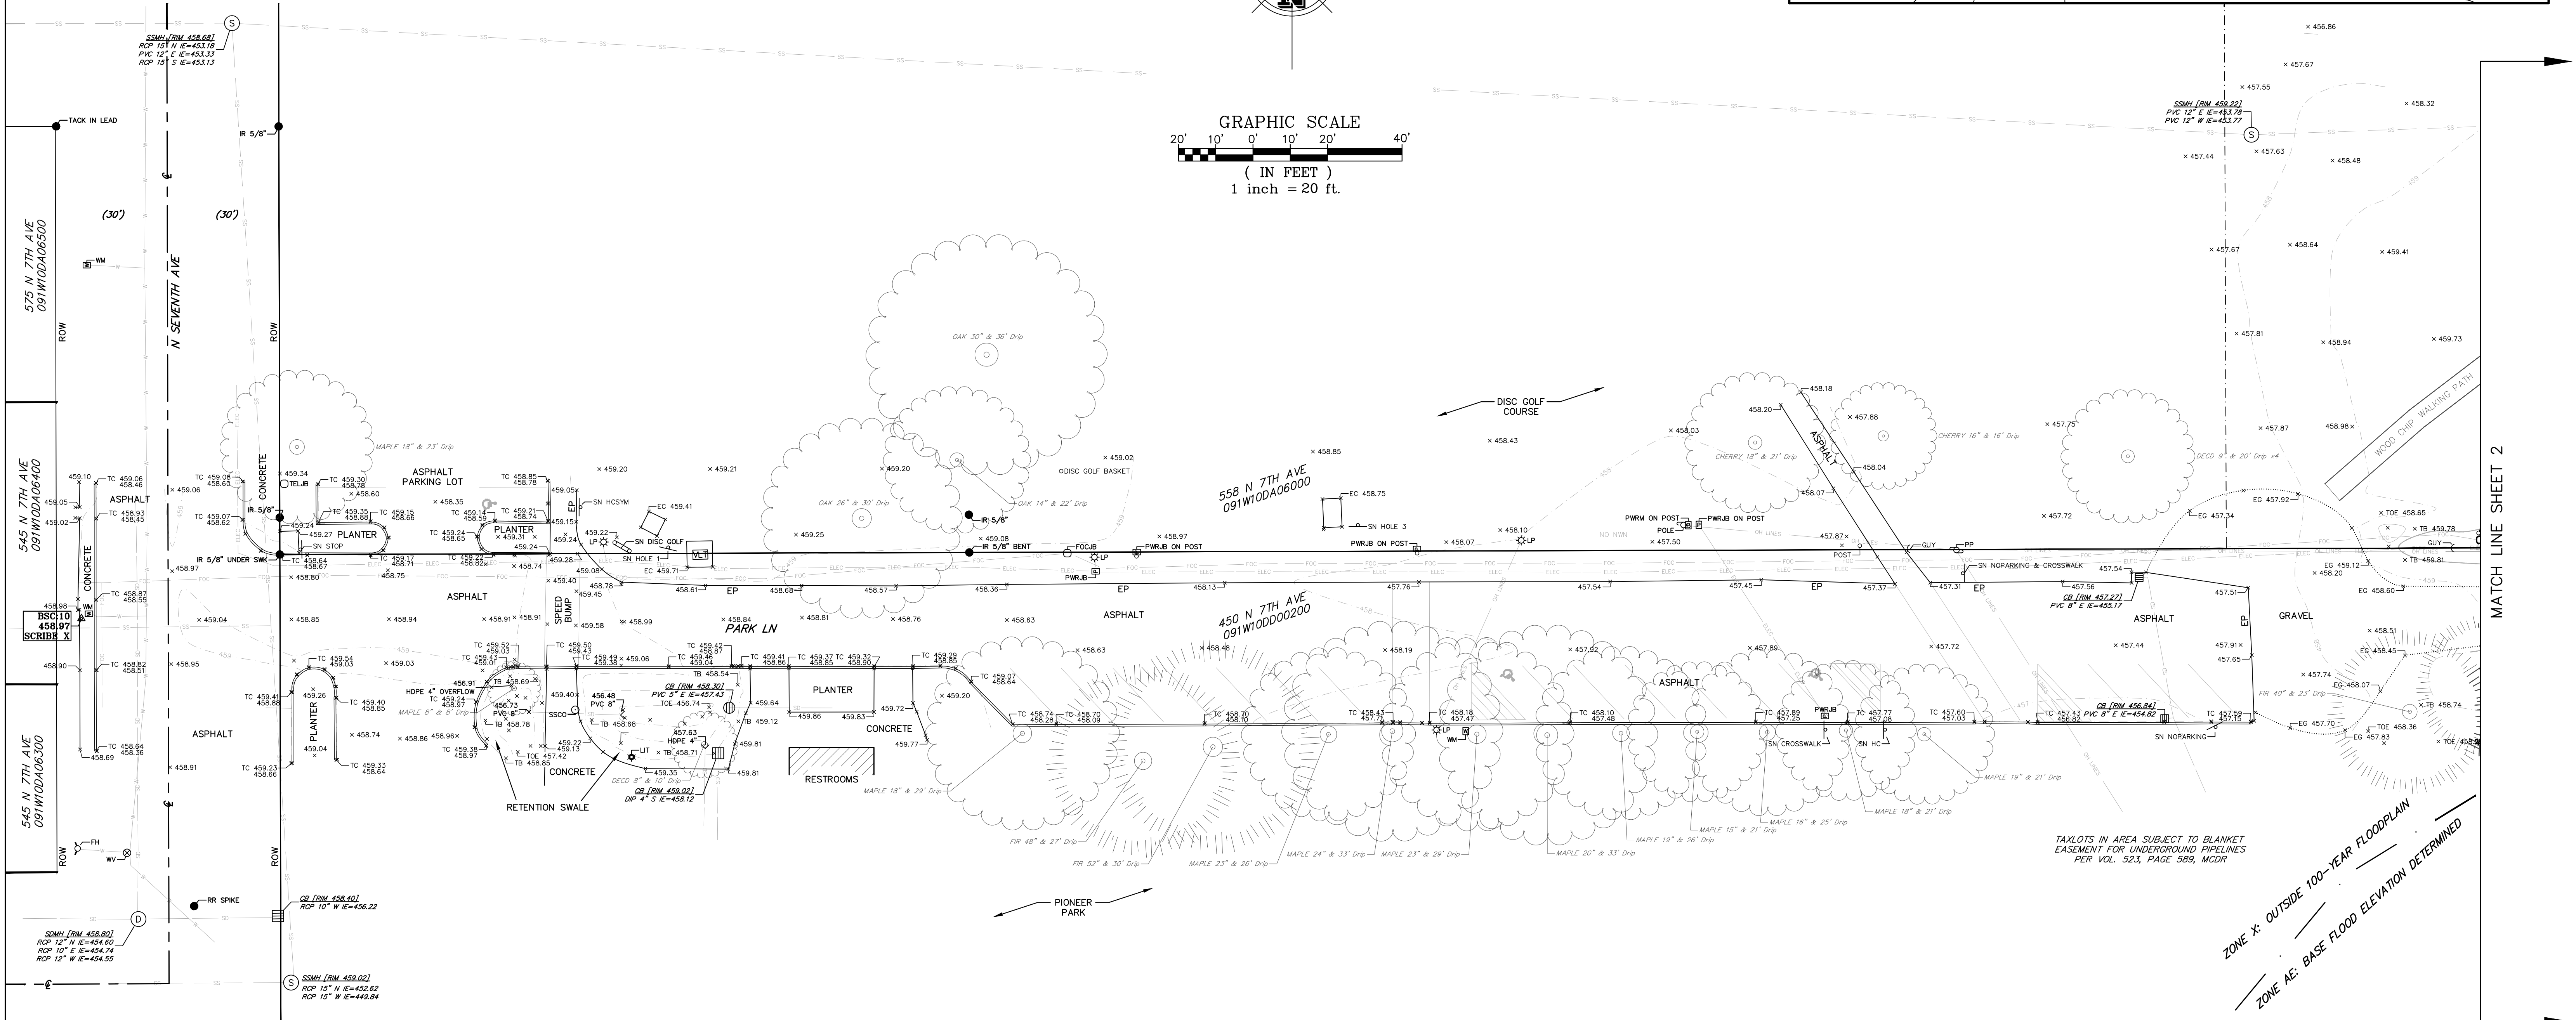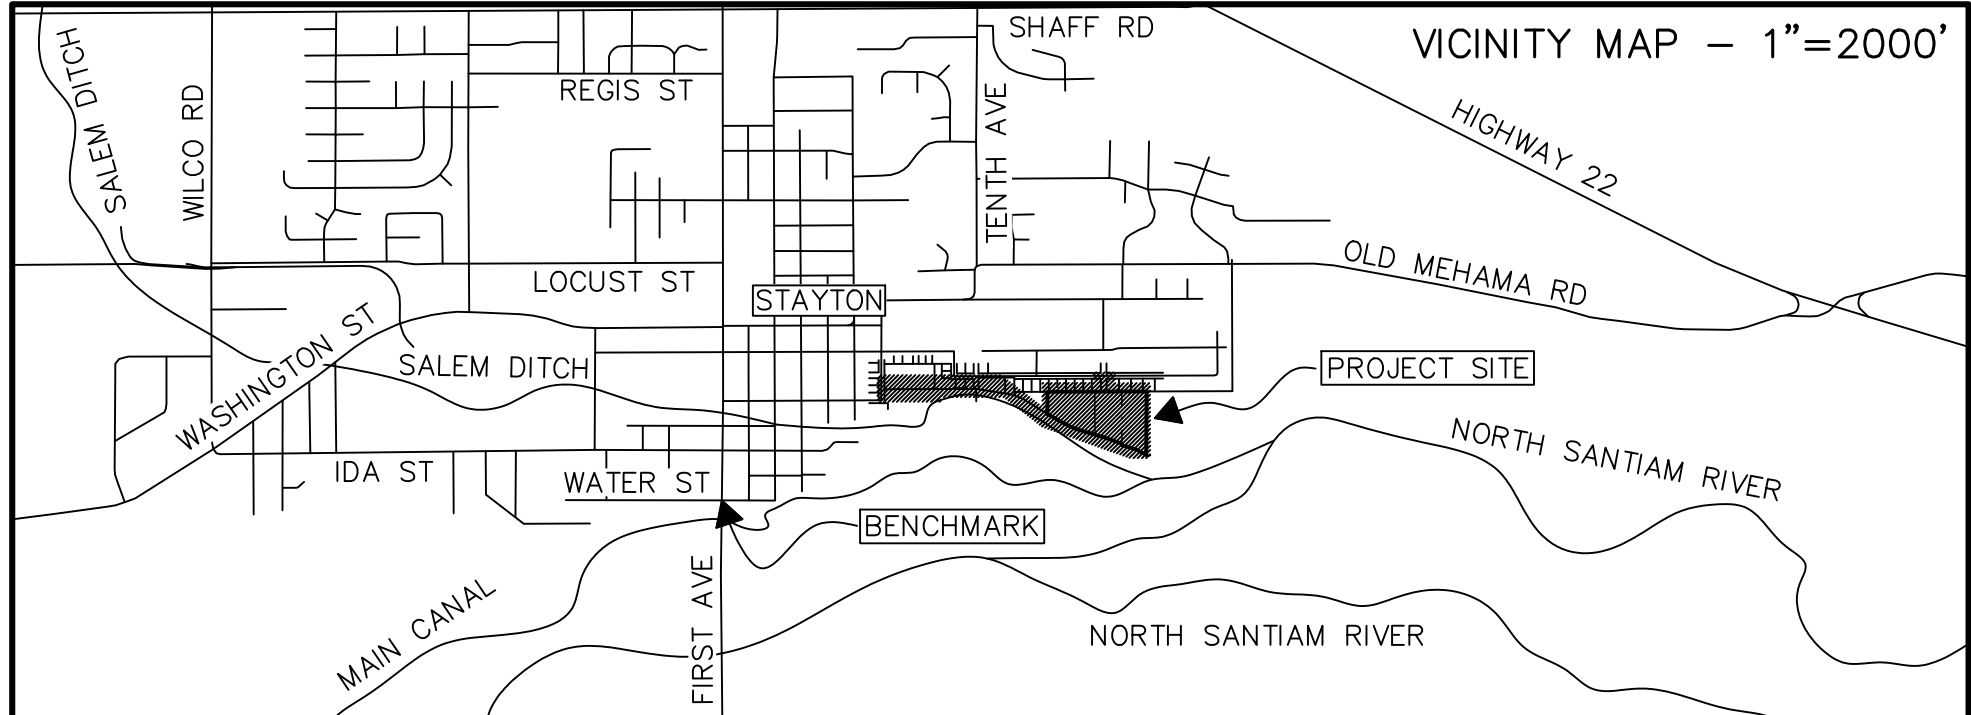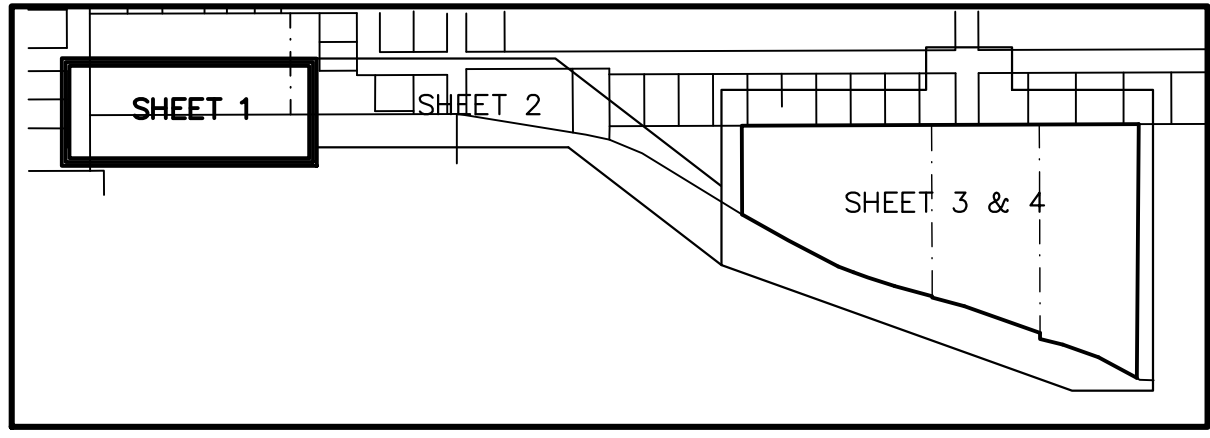

REGISTERED
PROFESSIONAL
LAND SURVEYOR

O R E G O N
JANUARY 10, 2023
BRAD ROBERT HARRIS
96889PLS
EXPIRES: 6/30/2027

SURVEY FOR	CLUTCH INDUSTRIES, INC
LOCATION:	1513 PARK LN
SE 1/4 SECTION 10 & SW 1/4 SECTION 11	STAYTON
T9S, R1W, W.M.	MARION COUNTY, OREGON
SCALE: 1"=20'	
DATE: 8/12/25	
DRAWN BY: S.C.P.	
BARKER SURVEYING 3637 KASHMIR WAY SE SALEM, OREGON 97317 PHONE (503) 588-8800 FAX (503) 363-2469 EMAIL: BRAD@BARKERWILSON.COM	SHEET 1 OF 4 JOB NUMBER: 42921



TOPOGRAPHIC SURVEY

DISCLAIMER: UTILITIES DEPICTED ARE BASED ON EVIDENCE FOUND IN THE FIELD, MUNICIPALITY AND/OR OTHER GOVERNMENT ENTITY AS-BUILT PLANS OF RECORD. BARKER SURVEYING ASSUMES NO RESPONSIBILITY FOR UTILITIES THAT ARE NO LONGER IN USE, INSTALLED AFTER THE DATE OF ACTUAL SURVEY, NOT IDENTIFIED OR NOT LOCATED. THIS INCLUDES UTILITIES UPON PUBLIC OR PRIVATE PROPERTY.


SPECIFIC UTILITY POSITIONS INDICATED ON THE GROUND SURFACE PROVIDED BY LOCATION SERVICES MAY VARY DUE TO UNDERGROUND DETECTION CAPABILITIES.

BENCHMARK UTILIZED: NGSS #QE0391
ELEV: 451.61' NAVD 88

MARK IS A 4" ALUMINUM DISK IN TOP FACE OF CURB RETURN AT NORTHWEST CORNER OF INTERSECTION OF WATER STREET AND 1ST AVENUE IN STAYTON.

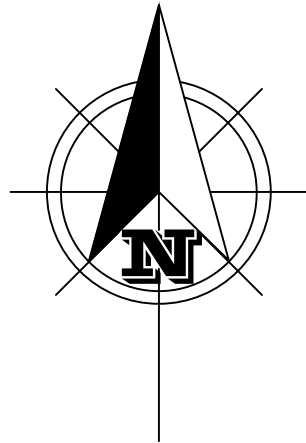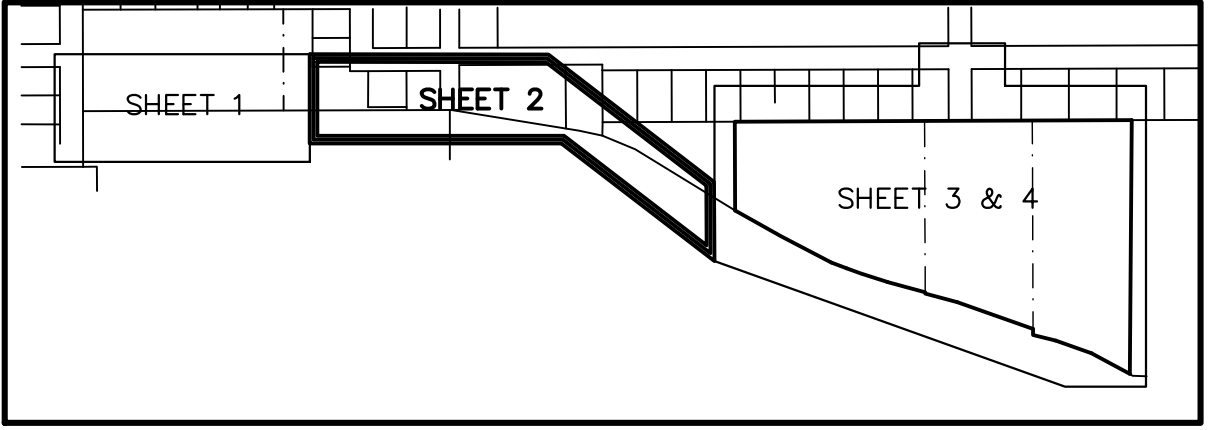

GRAPHIC SCALE
(IN FEET)
1 inch = 20 ft.

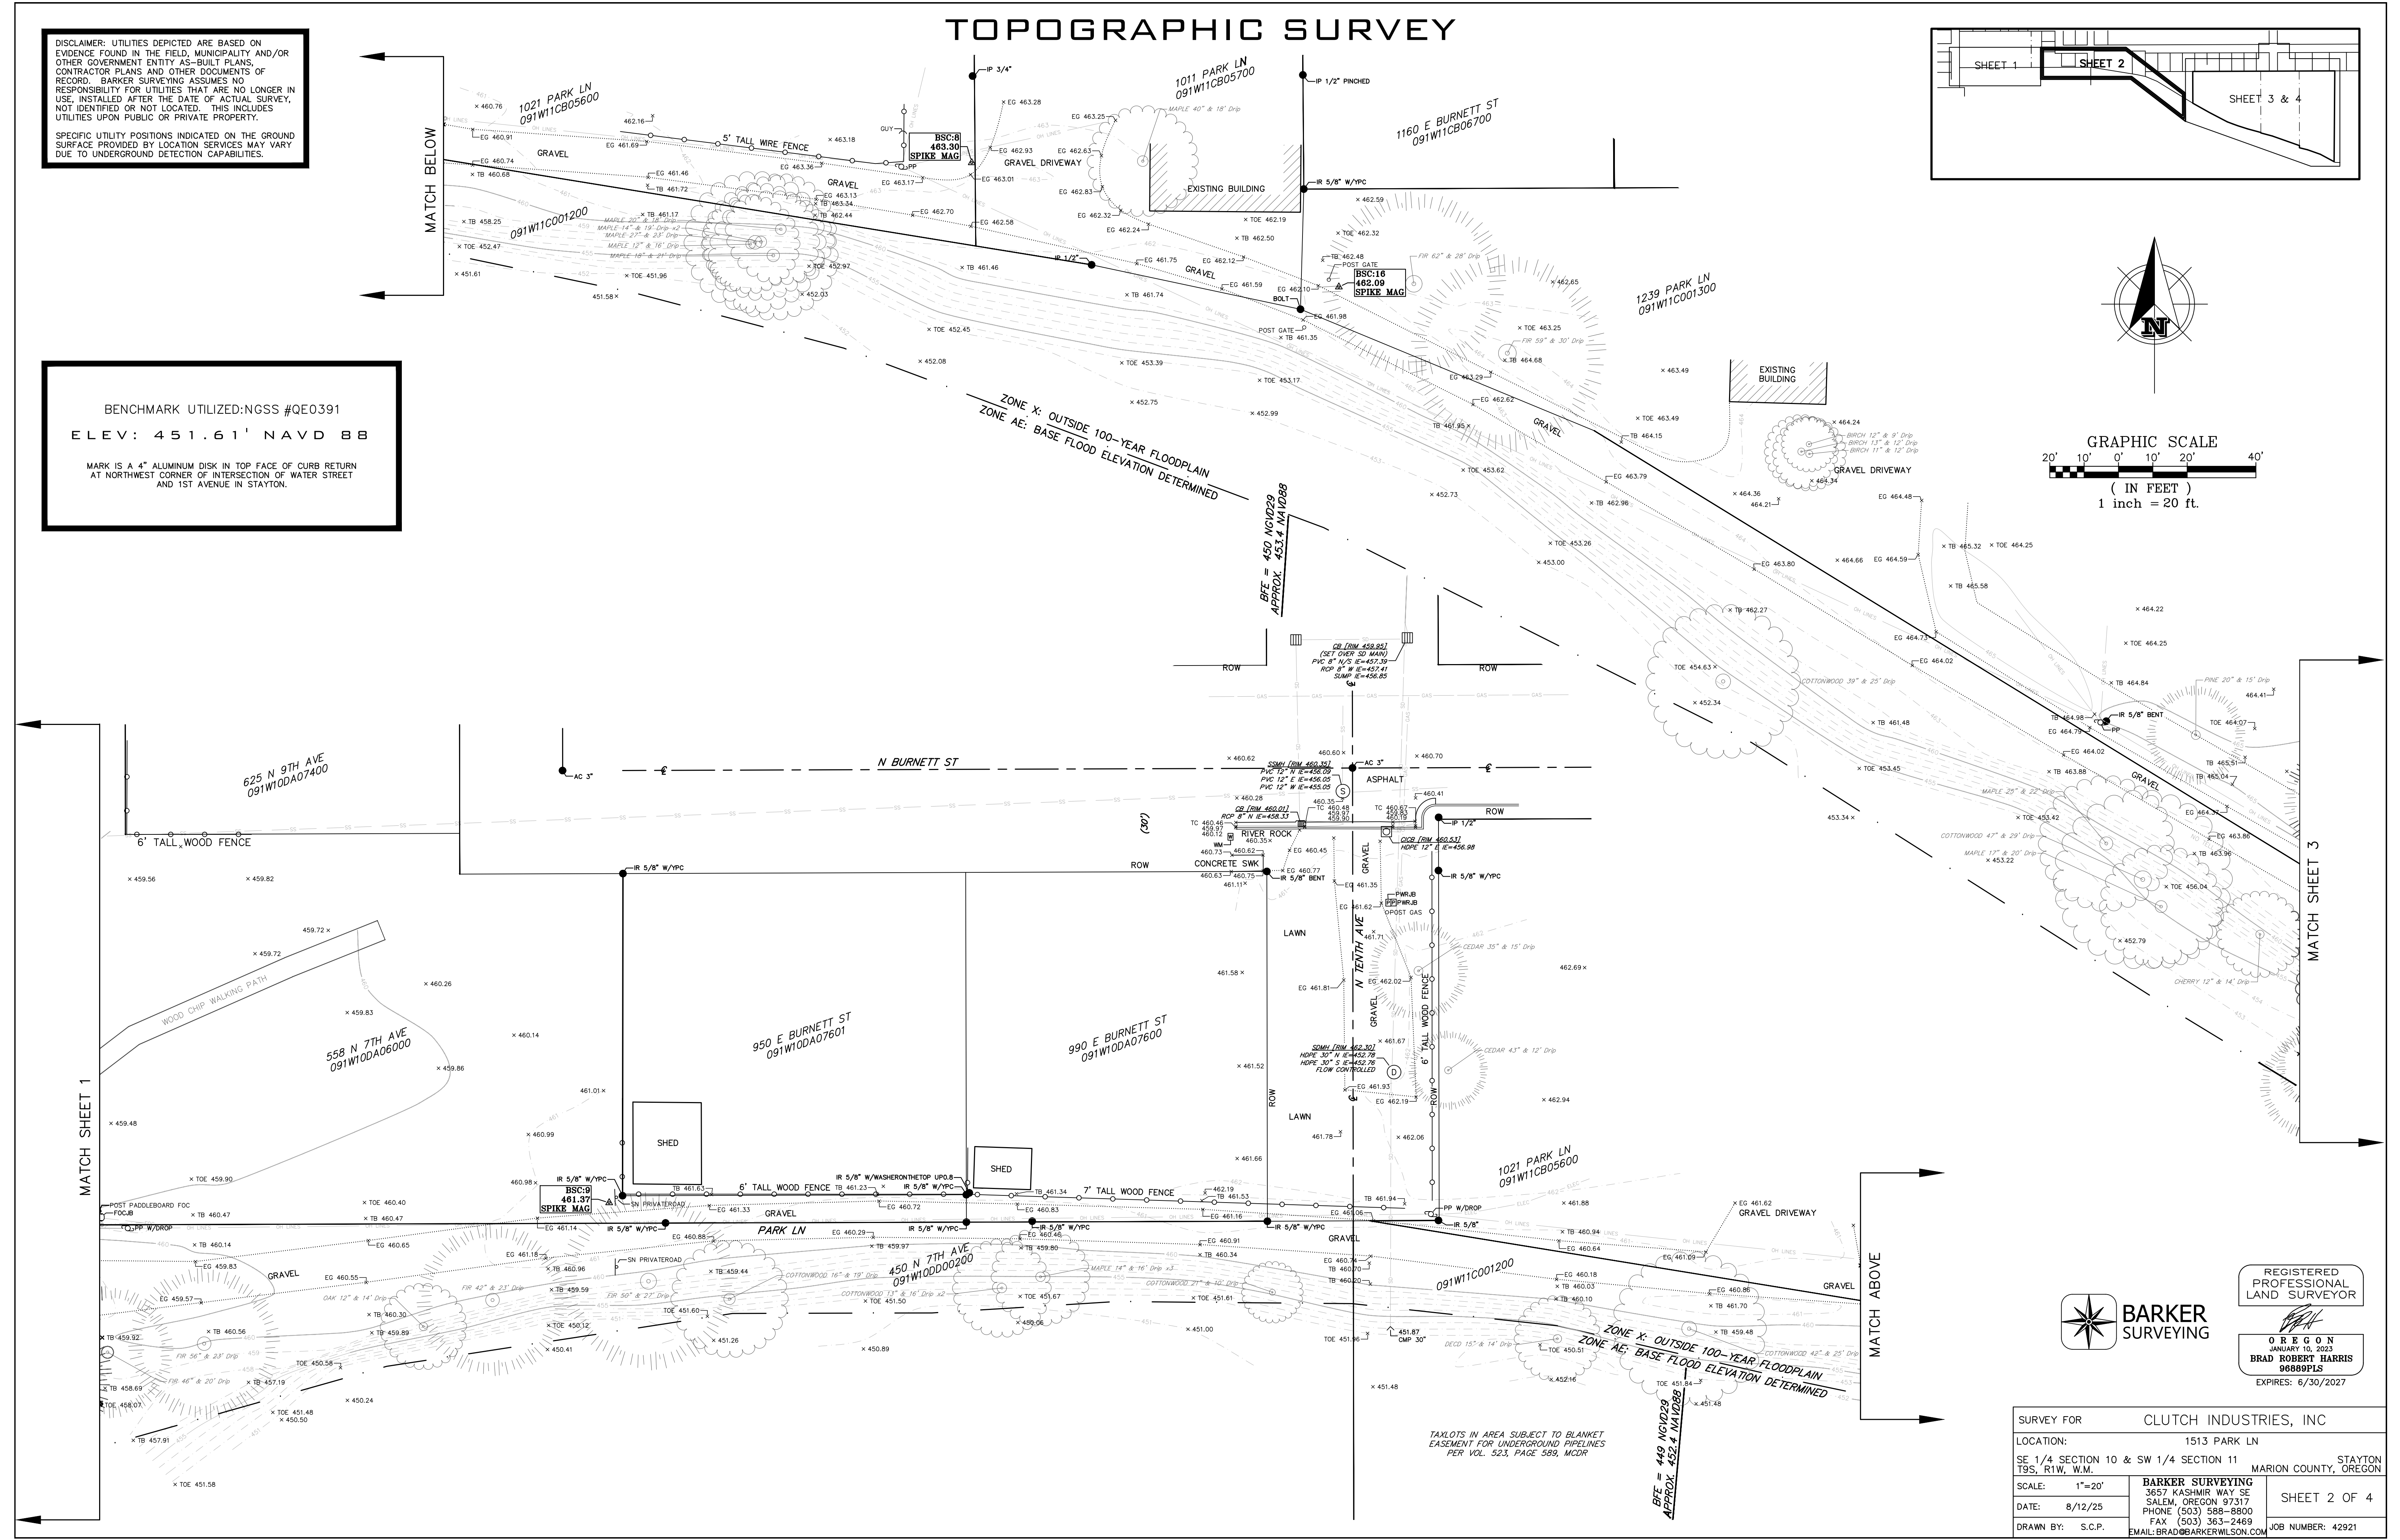


REGISTERED
PROFESSIONAL
LAND SURVEYOR





BRH
O R E G O N
JANUARY 10, 2023
BRAD ROBERT HARRIS
96889PLS
EXPIRES: 6/30/2027

SURVEY FOR		CLUTCH INDUSTRIES, INC	
LOCATION:		1513 PARK LN	
SE 1/4 SECTION 10 & SW 1/4 SECTION 11		STAYTON	
T9S, R1W, W.M.		MARION COUNTY, OREGON	
SCALE:	1"=20'	BARKER SURVEYING	
DATE:	8/12/25	3637 KASHMIR WAY SE SALEM, OREGON 97317	
DRAWN BY:	S.C.P.	PHONE (503) 588-8800	
		FAX (503) 363-2469	
		EMAIL: BRAD@BARKERWILSON.COM	
		JOB NUMBER: 42921	
		SHEET 2 OF 4	

TOPOGRAPHIC SURVEY

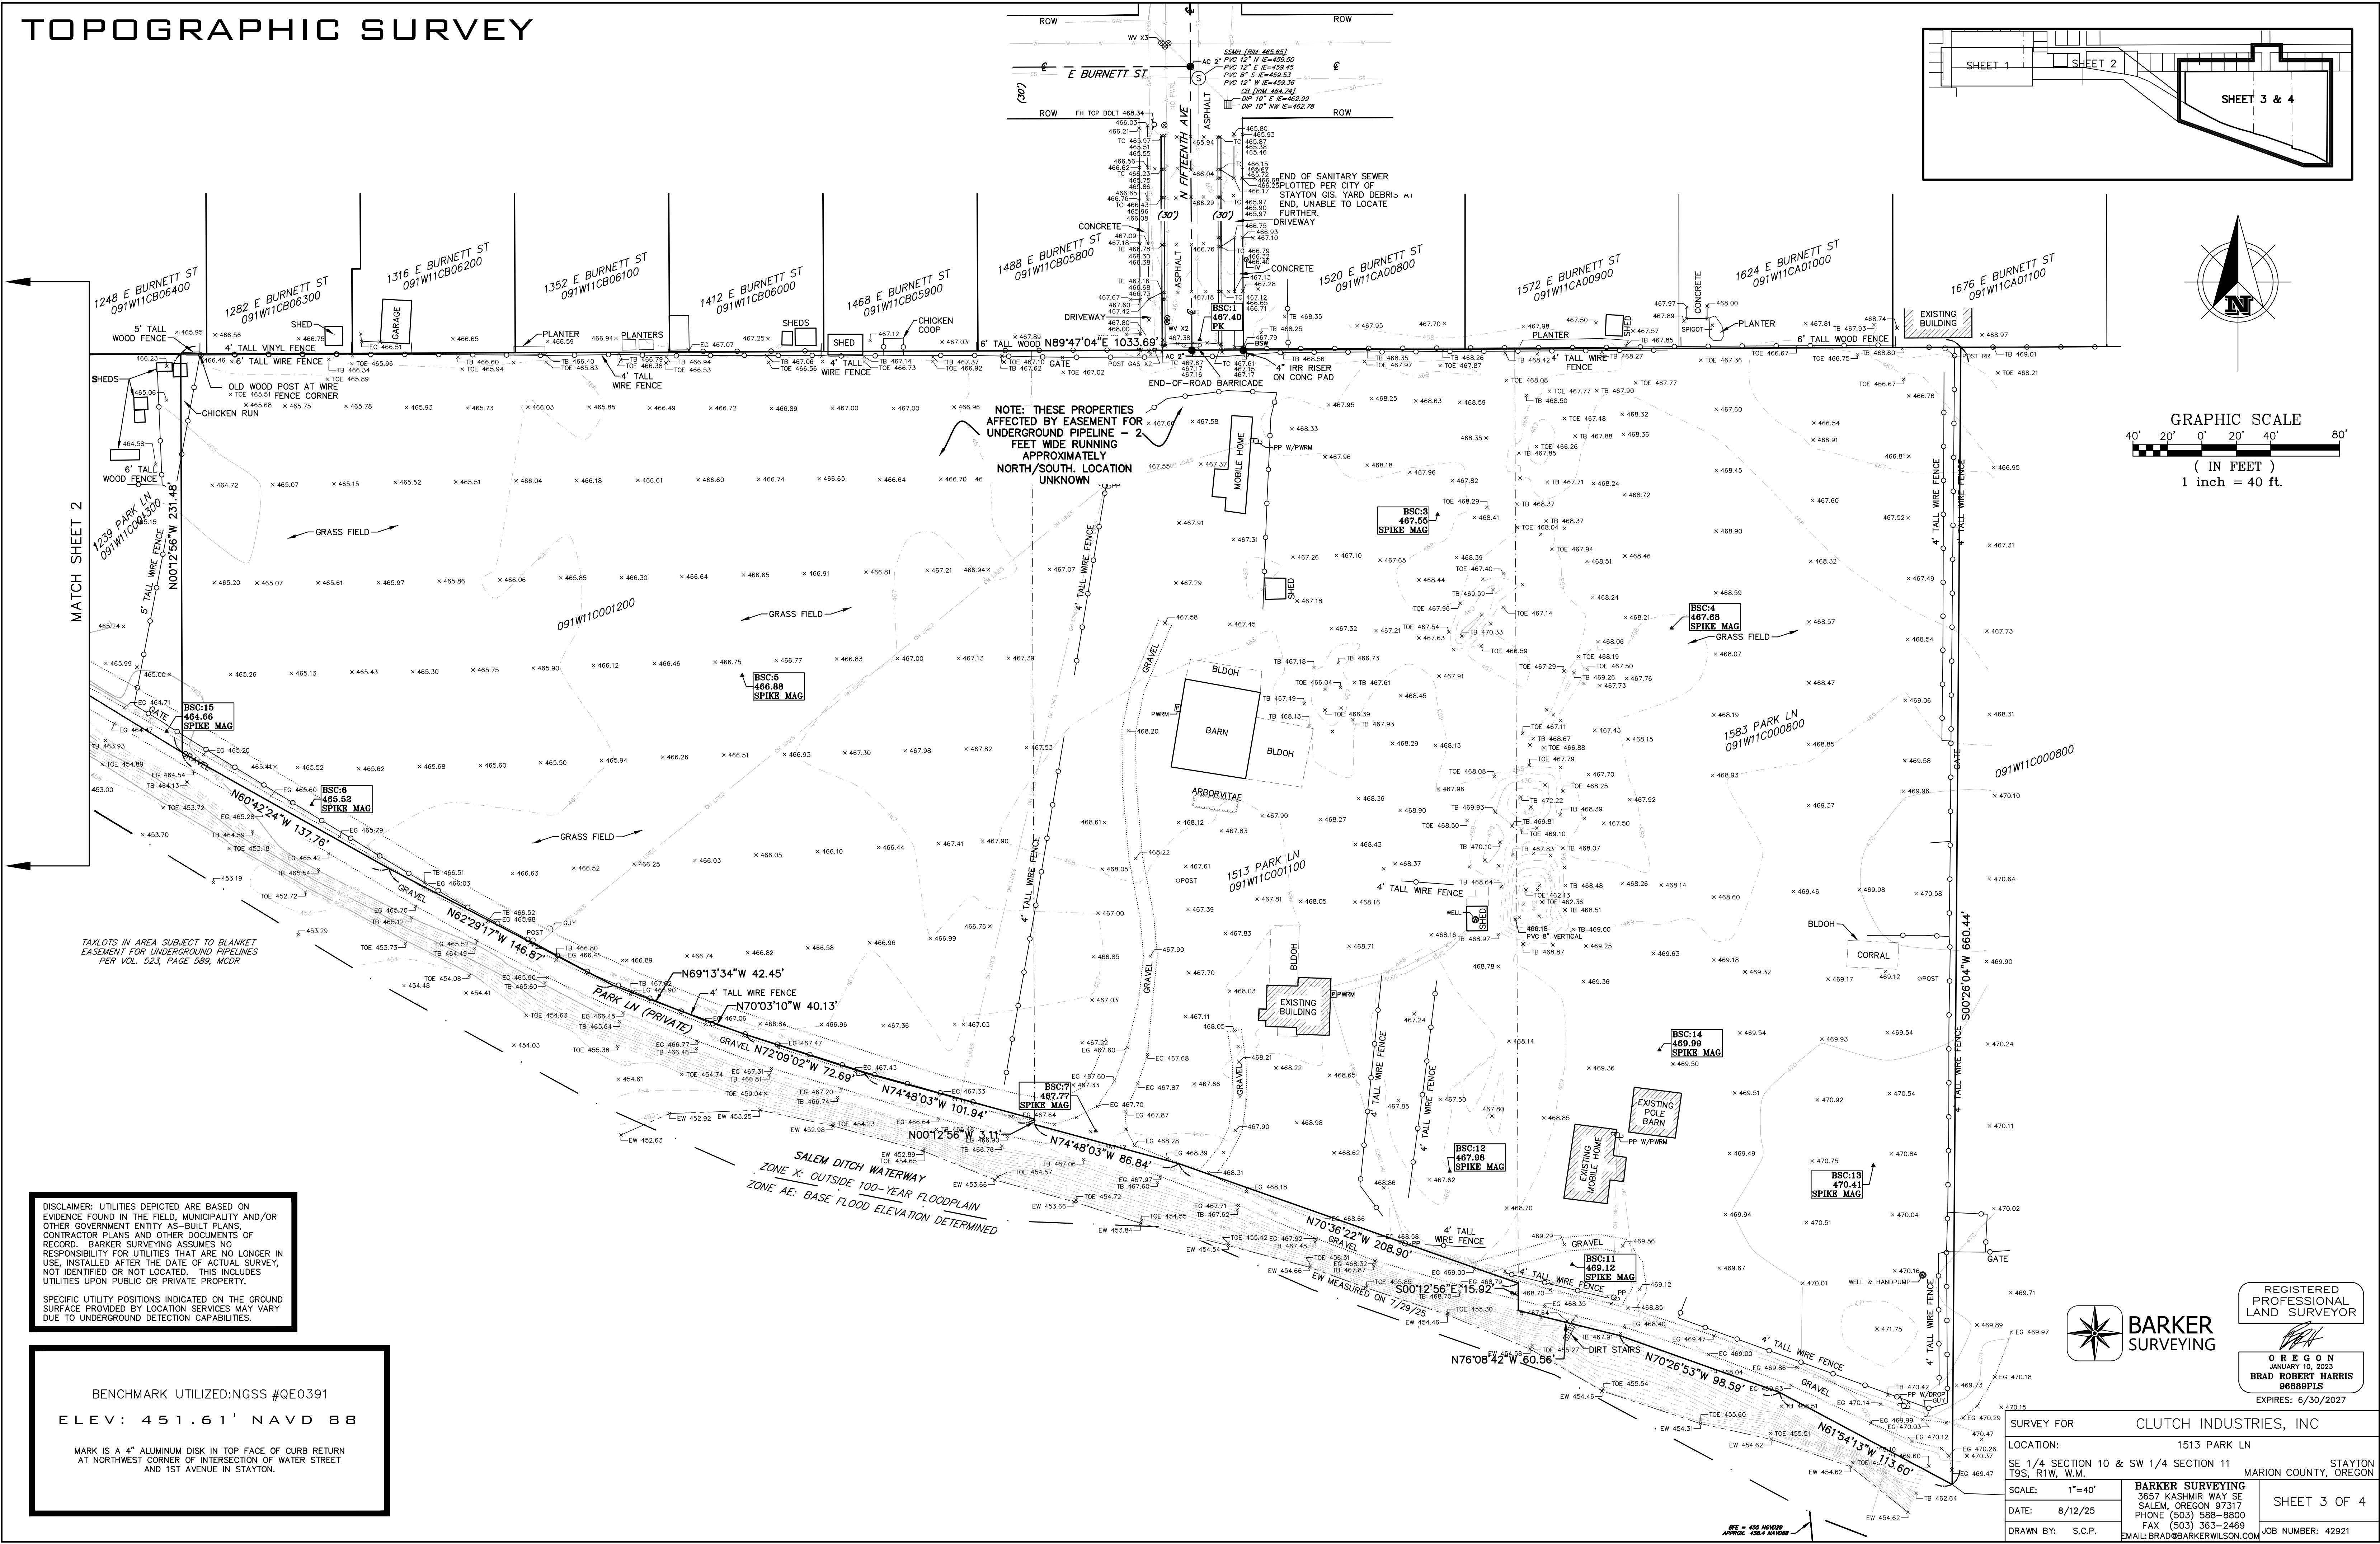

TOPOGRAPHIC SURVEY

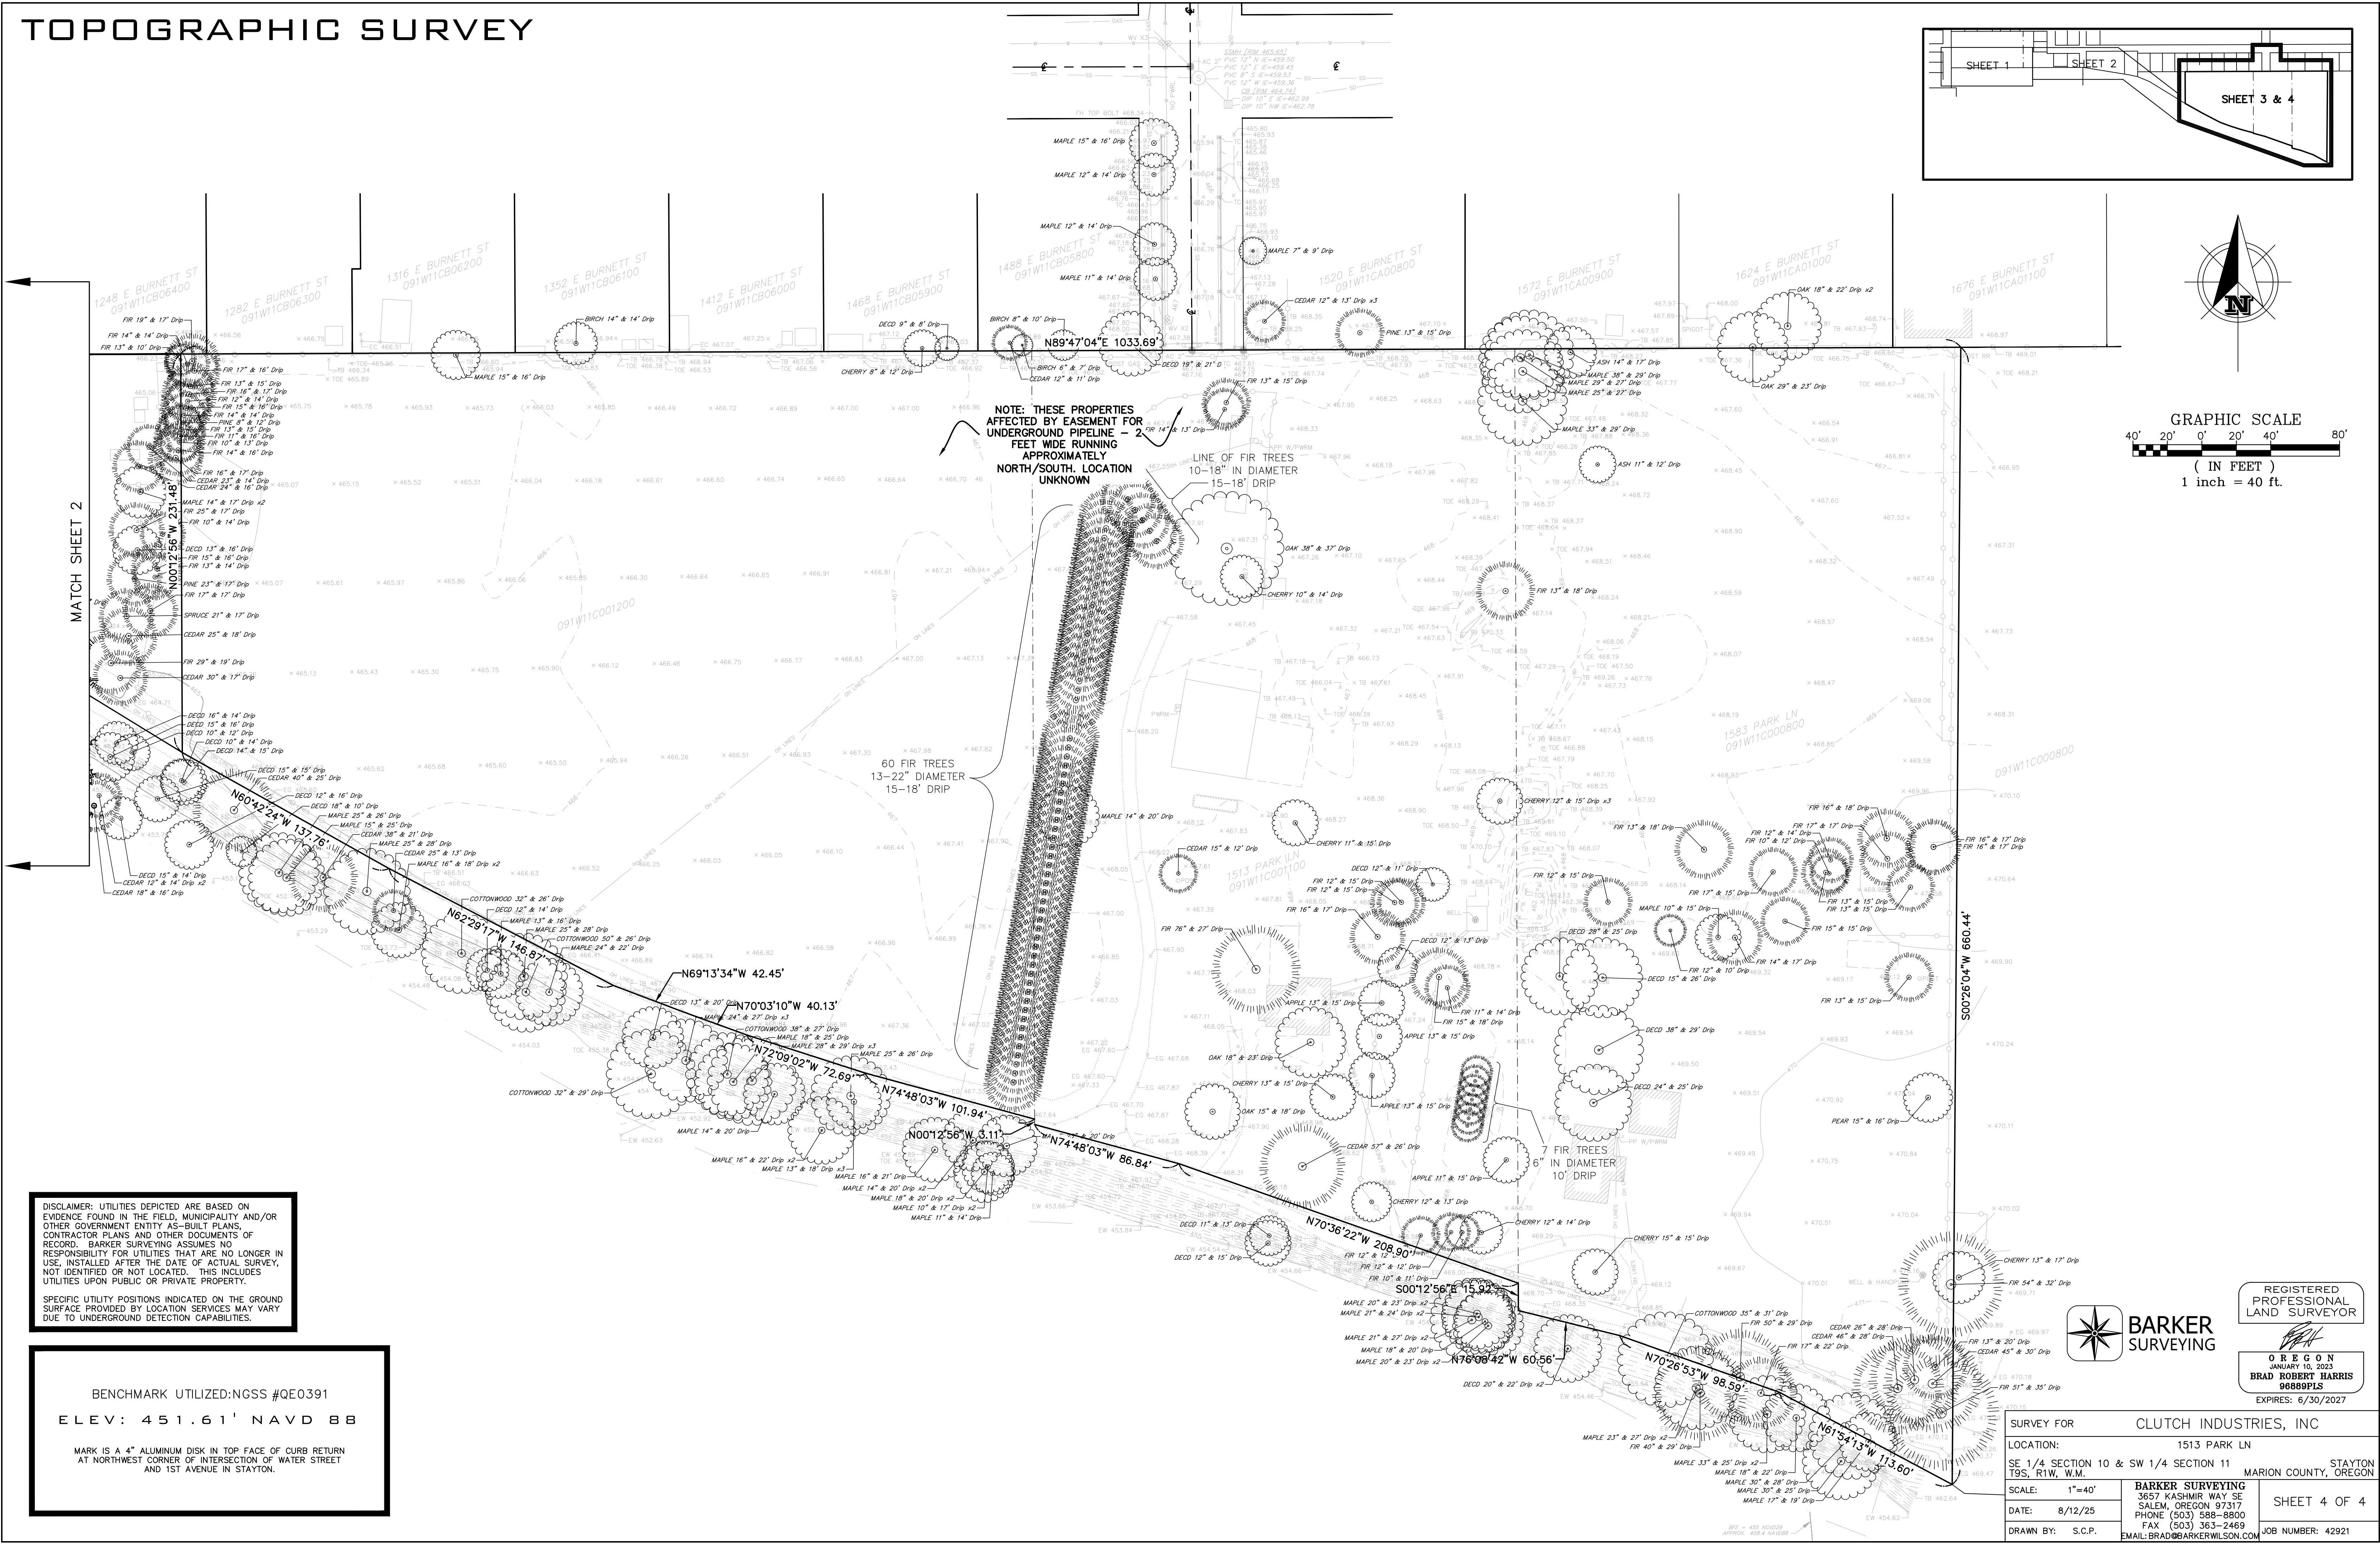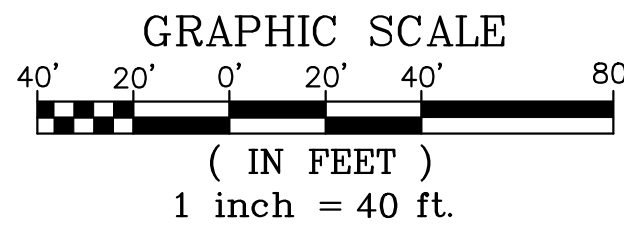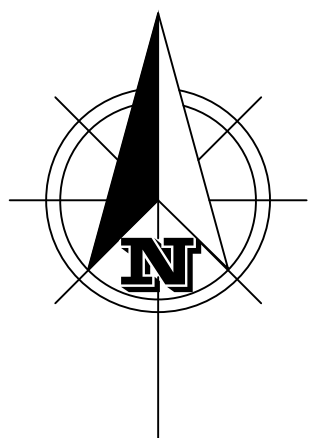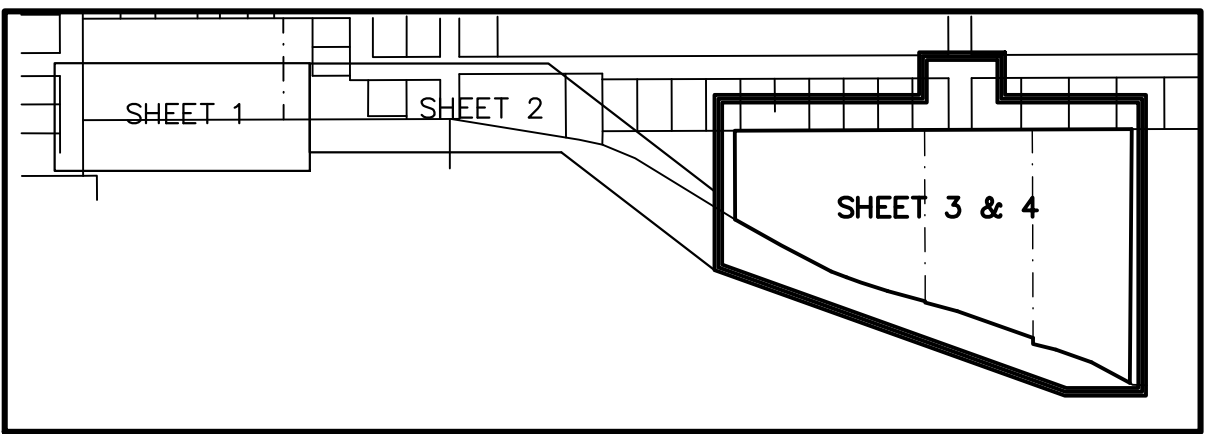

DISCLAIMER: UTILITIES DEPICTED ARE BASED ON EVIDENCE FOUND IN THE FIELD, MUNICIPALITY AND/OR OTHER GOVERNMENT ENTITY AS-BUILT PLANS, CONTRACTOR PLANS AND OTHER DOCUMENTS OF RECORD. BARKER SURVEYING ASSUMES NO RESPONSIBILITY FOR UTILITIES THAT ARE NO LONGER IN USE, INSTALLED AFTER THE DATE OF ACTUAL SURVEY, NOT IDENTIFIED OR NOT LOCATED. THIS INCLUDES UTILITIES UPON PUBLIC OR PRIVATE PROPERTY.

SPECIFIC UTILITY POSITIONS INDICATED ON THE GROUND SURFACE PROVIDED BY LOCATION SERVICES MAY VARY DUE TO UNDERGROUND DETECTION CAPABILITIES.

BENCHMARK UTILIZED: NGSS #QE0391
ELEV: 451.61' NAVD 88

MARK IS A 4" ALUMINUM DISK IN TOP FACE OF CURB RETURN AT NORTHWEST CORNER OF INTERSECTION OF WATER STREET AND 1ST AVENUE IN STAYTON.



REGISTERED
PROFESSIONAL
LAND SURVEYOR

OREGON
JANUARY 10, 2023
BRAD ROBERT HARRIS
98889PLS
EXPIRES: 6/30/2027

SURVEY FOR	CLUTCH INDUSTRIES, INC
LOCATION:	1513 PARK LN SE 1/4 SECTION 10 & SW 1/4 SECTION 11 T9S, R1W, W.M. STAYTON MARION COUNTY, OREGON
SCALE:	1"=40'
DATE:	8/12/25
DRAWN BY:	S.C.P.
BARKER SURVEYING 3657 KASHMIR WAY SE SALEM, OREGON 97317 PHONE (503) 588-8800 FAX (503) 363-2469 EMAIL: BRAD@BARKERWILSON.COM	SHEET 4 OF 4 JOB NUMBER: 42921