



ALTA/ACSM LAND TITLE SURVEY



FHA PROJECT NO. 126-13008

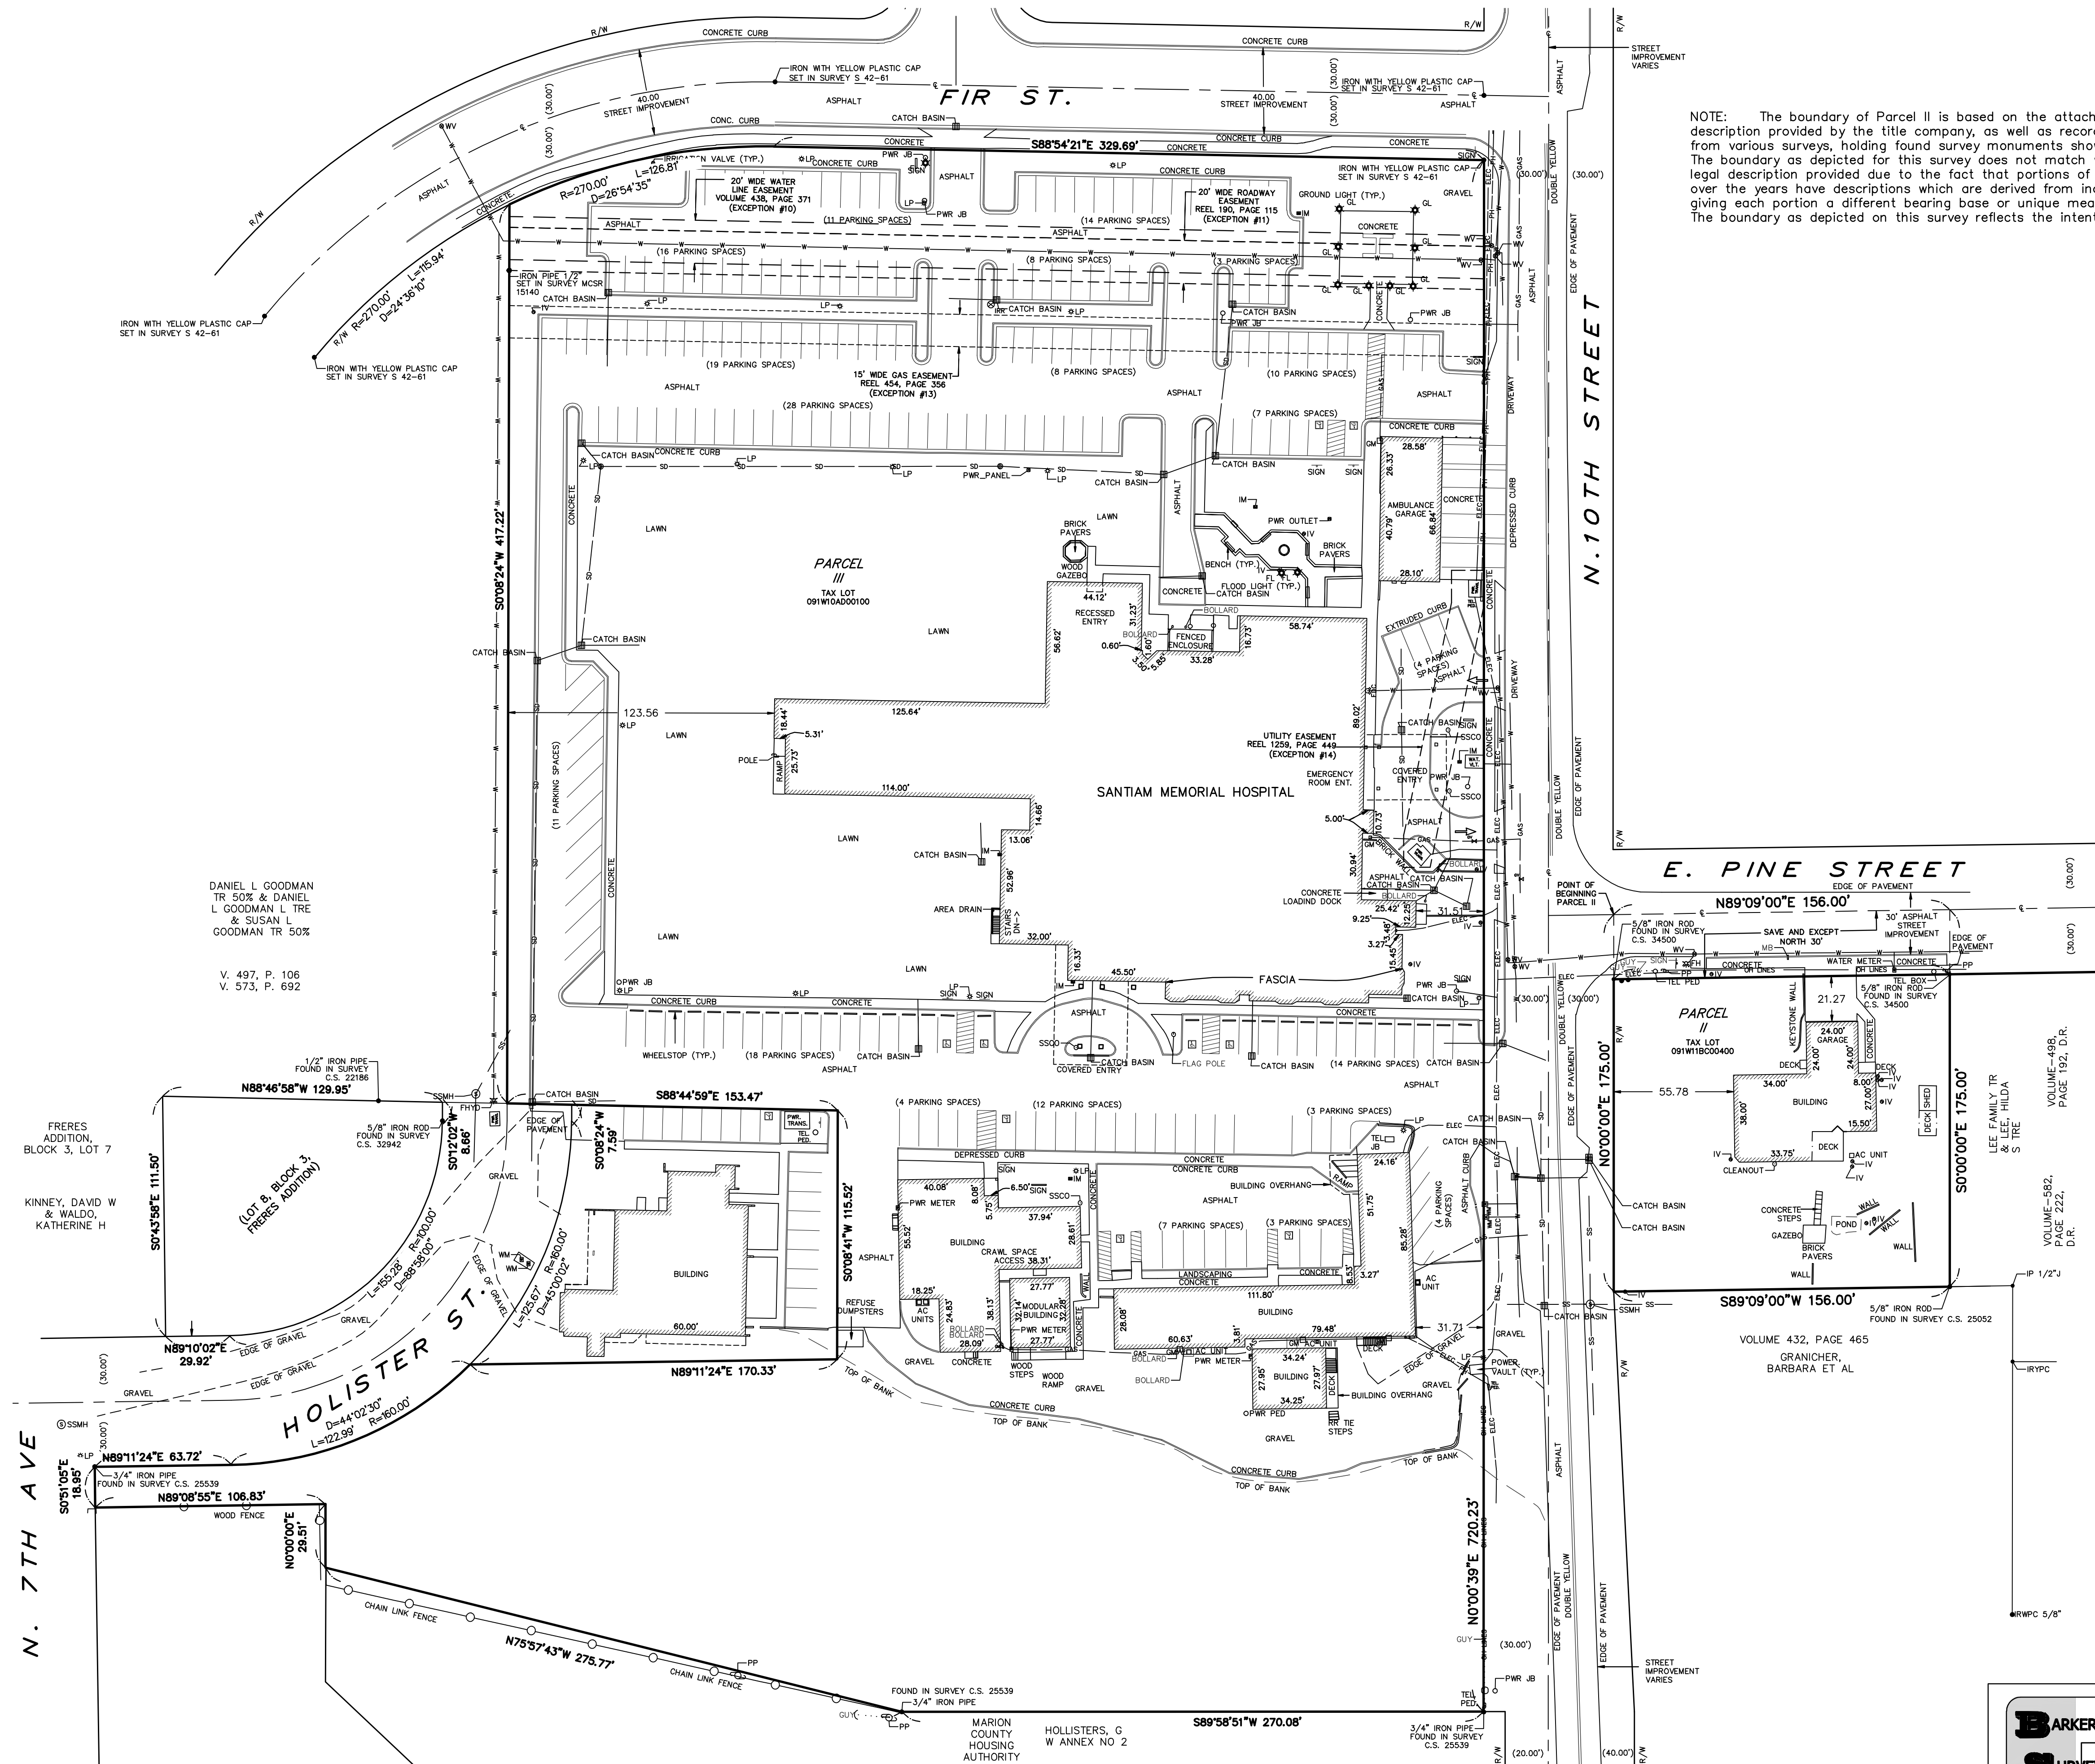

NOTE: The boundary of Parcel II is based on the attached legal description provided by the title company, as well as record survey data from various surveys, holding found survey monuments shown on this map. The boundary as depicted for this survey does not match word for word the legal description provided due to the fact that portions of property acquired over the years have descriptions which are derived from independent surveys giving each portion a different bearing base or unique measured distance. The boundary as depicted on this survey reflects the intent of the deeds recorded.

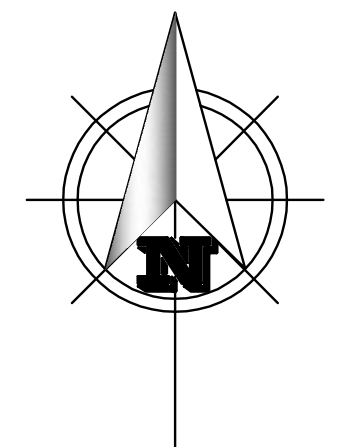

0 20 40 80
(IN FEET)
1 inch = 40 ft.

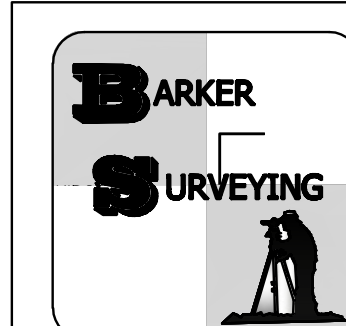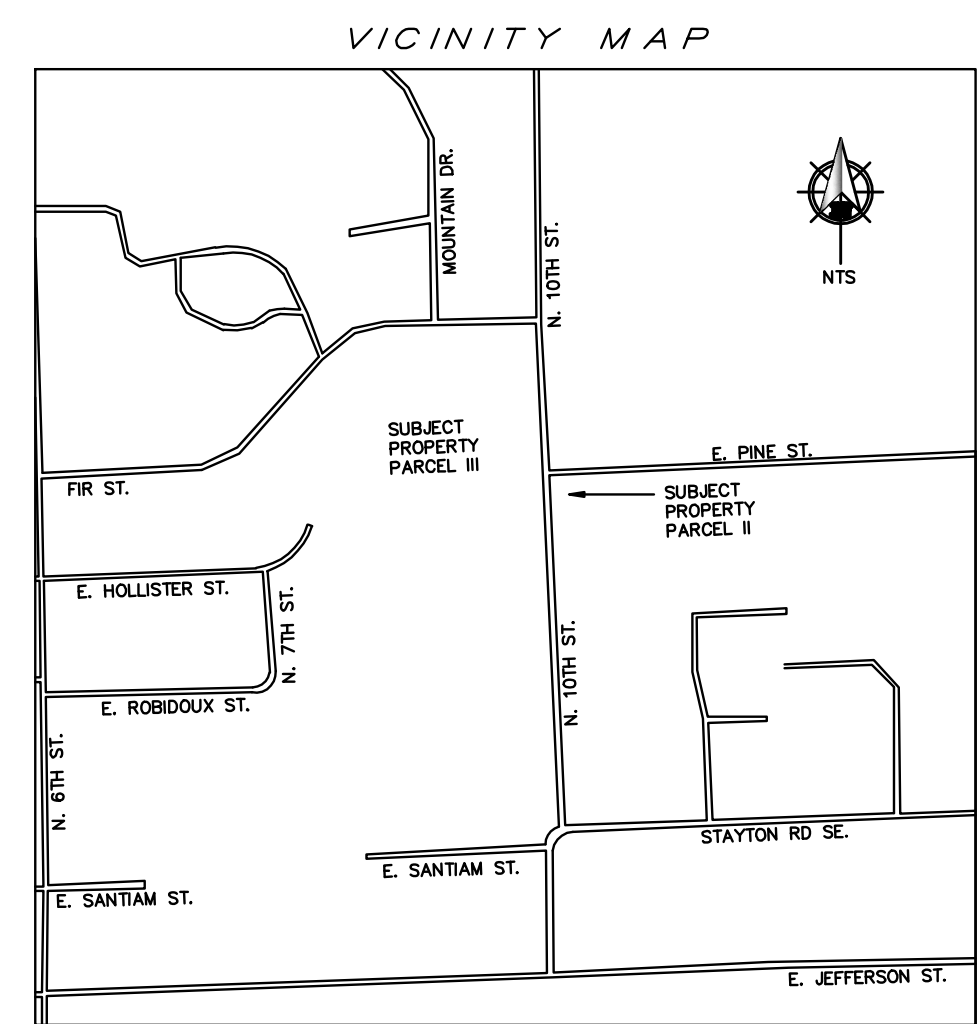

REGISTERED
PROFESSIONAL
LAND SURVEYOR

Gregory L. Wilson
OREGON
JULY 19, 1994
GREGORY L. WILSON
2887
EXPIRATION DATE: 6/30/2012

SURVEY FOR SANTIAM MEMORIAL HOSPITAL

LOCATION: 1401 N. 10TH AVE. & 1208 E. PINE ST.

SE 1/4, NE 1/4 SECTION 10
T.9S., R.1W., W.M. CITY OF STAYTON
MARION COUNTY, OREGON

SCALE: 1" = 40'
DATE: 1/4/2010
REVISED: 10/27/2010
DRAWN BY: M.P.W.
BARKER SURVEYING
3657 KASHMIR WAY SE
SALEM, OREGON 97317
PHONE (503) 588-8800
FAX (503) 363-2469
EMAIL: INFO@BARKERWILSON.COM
SHEET 3 OF 6
JOB NUMBER: 91424